

KEY PLAN




10440 N. Central Expy., Suite 500

Dallas, TX 75231

972.437.2444

FOR LEASING INFORMATION  
 CONTACT: ALEXIS MARTINEZ  
 AMARTINEZ@PILLARCOMMERCIAL.COM

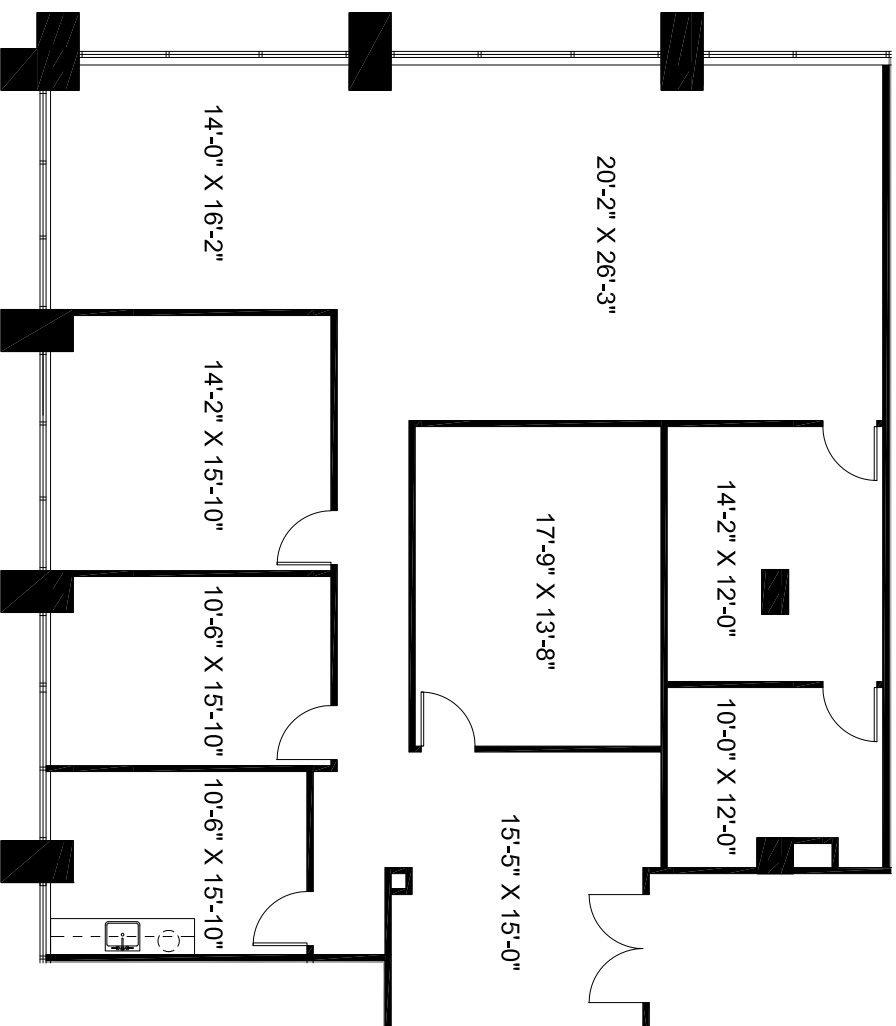

# TOLL HILL EAST

5440 HARVEST HILL  
 DALLAS, TEXAS 75230

AS-BUILT PLAN  
 SUITE 230

rsf: 2,776

scale: n.t.s.

date: 10.08.09



208 north market street  
 suite 420  
 dallas, texas 75202  
 214.420.4646