


KEY PLAN



10440 N. Central Expy., Suite 500  
 Dallas, TX 75231  
 972.437.2444

FOR LEASING INFORMATION  
 CONTACT: JAROD JAGGERS  
 JJAGGERS@PILLARCOMMERCIAL.COM

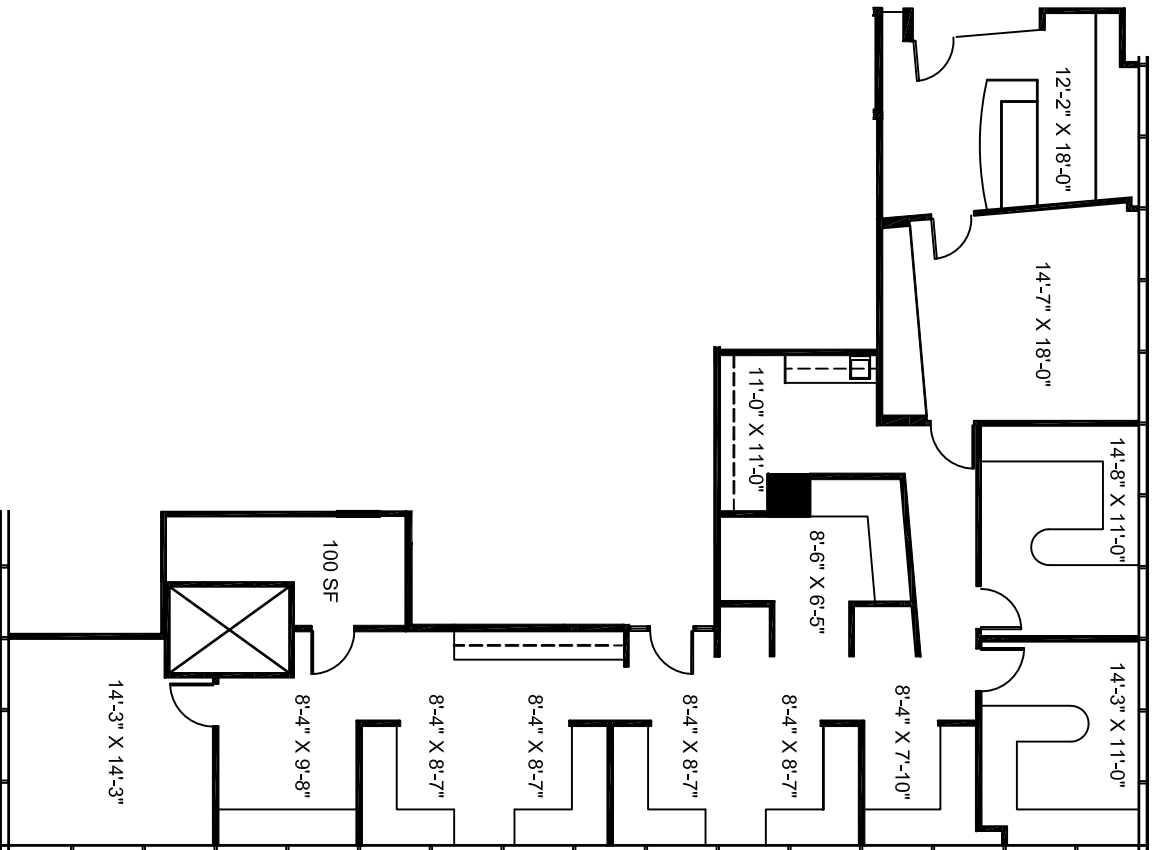

**7515**  
 7515 GREENVILLE AVENUE  
 DALLAS, TEXAS 75206  
**AS-BUILT PLAN**  
 SUITE 307

rsf: 2,704

scale: NTS

date: 02.24.09

208 north market street  
 suite 420  
 dallas, texas 75202  
 214.420.4646

