


KEY PLAN

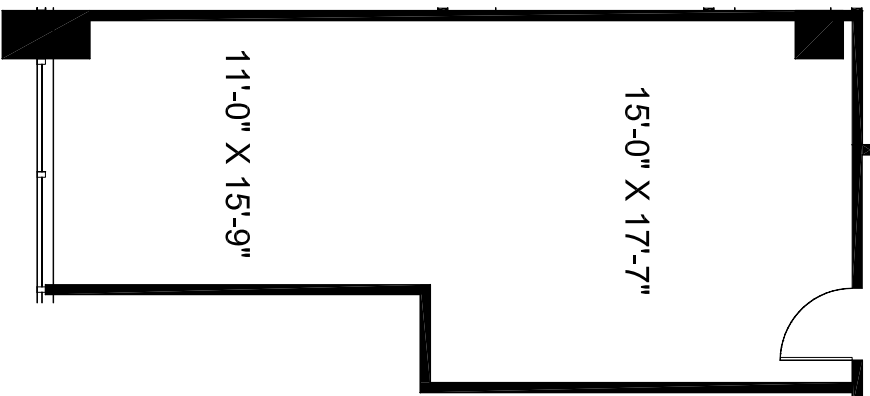

10440 N. Central Expy., Suite 500
Dallas, TX 75231
972.437.2444

FOR LEASING INFORMATION
CONTACT: NICK CLARK
NCLARK@PILLARCOMMERCIAL.COM

WELLS FARGO TOWER

800 W. AIRPORT FREEWAY
IRVING, TEXAS 75062
AS-BUILT PLAN
SUITE 328

rsf: 535

scale: 1/8" = 1'-0"

date: 05.04.10



208 north market street
suite 420
dallas, texas 75202
214.420.4646