


KEY PLAN

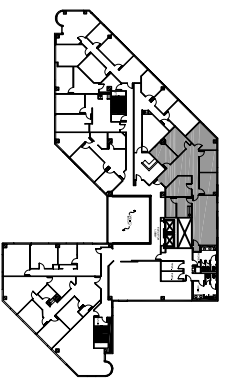

10440 N. Central Expy., Suite 500
 Dallas, TX 75231
 972.437.2444

FOR LEASING INFORMATION
 CONTACT: ALEXIS MARTINEZ
 AMARTINEZ@PILLARCOMMERCIAL.COM

WELLS FARGO TOWER

3939 BELT LINE ROAD
 ADDISON, TEXAS 75001
AS-BUILT PLAN
 SUITE 299

rsf: 2,131

scale: NTS

date: 06.05.09



208 north market street
 suite 420
 dallas, texas 75202
 214.420.4646