


KEY PLAN

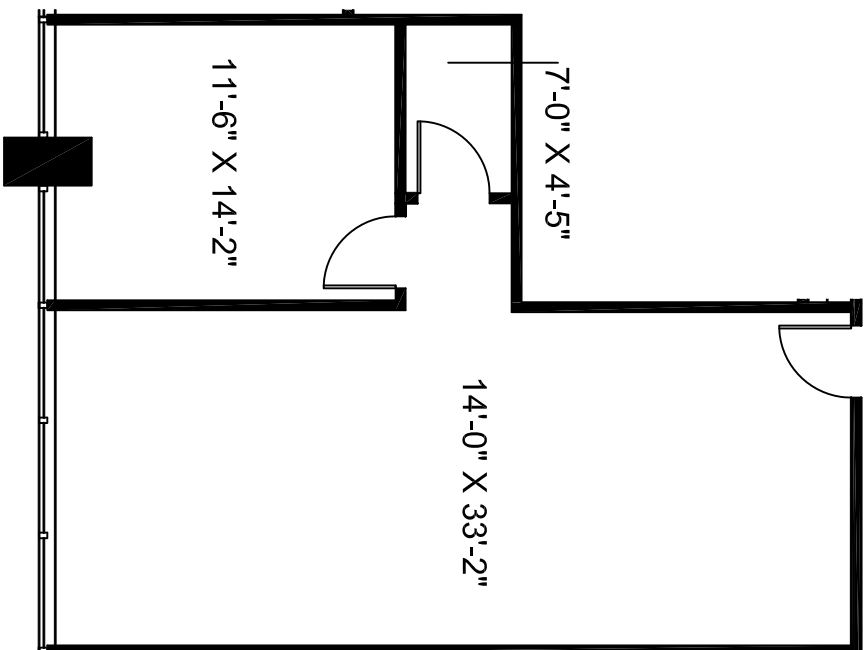

10440 N. Central Expy., Suite 500
 Dallas, TX 75231
 972.437.2444

FOR LEASING INFORMATION
 CONTACT: NICK CLARK
 NCLARK@PILLARCOMMERCIAL.COM

WELLS FARGO TOWER

800 W. AIRPORT FREEWAY
 IRVING, TEXAS 75062
AS-BUILT PLAN
 SUITE 920

rsf: 834

scale: 1/8" = 1'-0"

date: 02.26.09



208 north market street
 suite 420
 dallas, texas 75202
 214.420.4646