


KEY PLAN

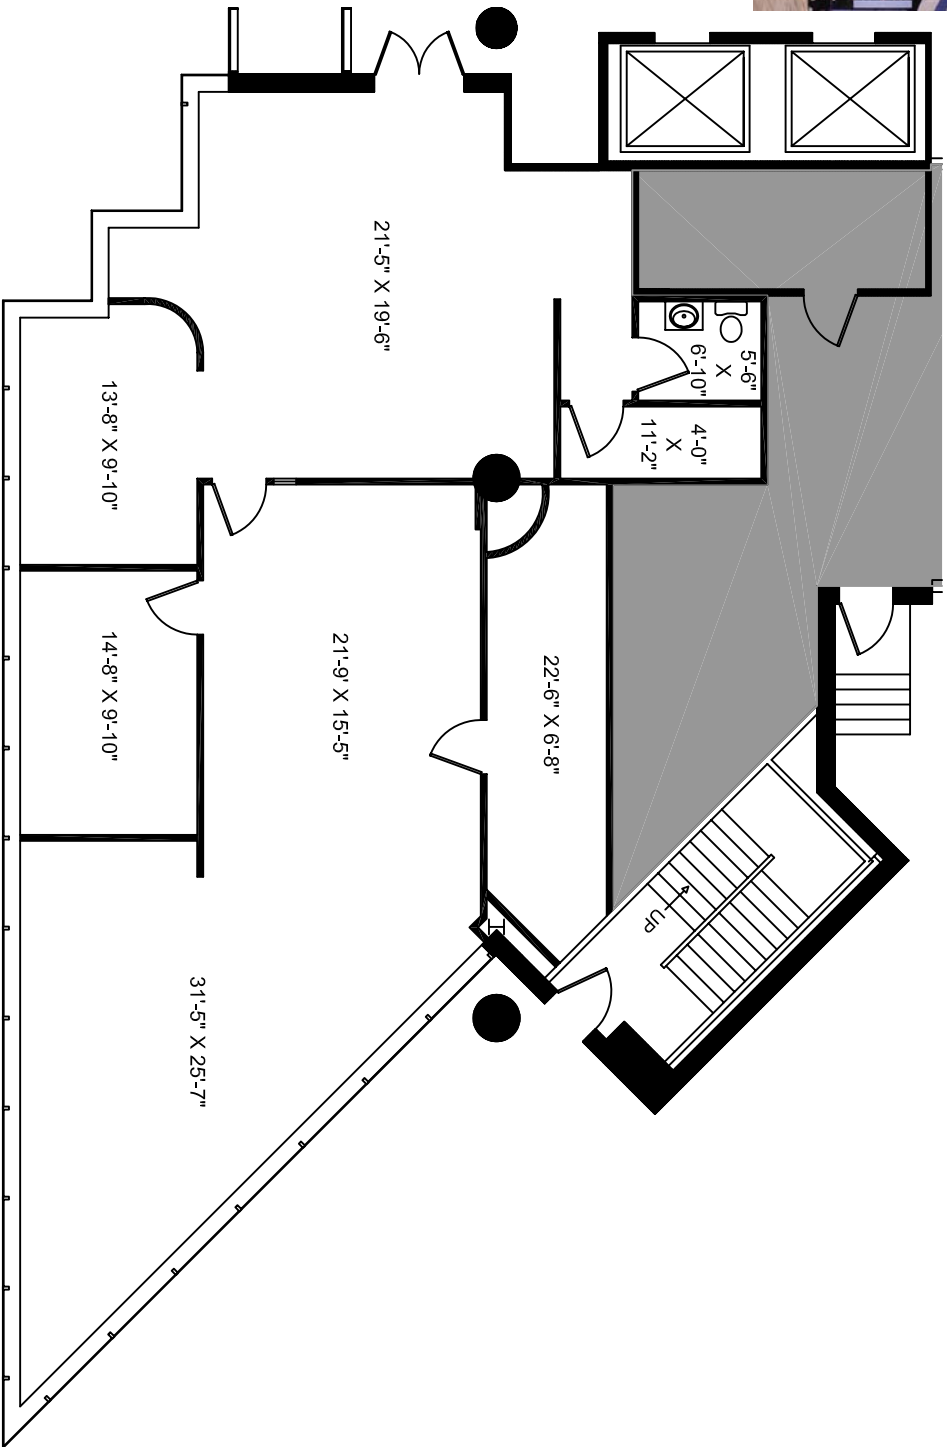

**PILLAR**  
COMMERCIAL  
12160 N. Abrams Rd., Suite 650  
Dallas, Texas 75243  
972.437.2444

**CHASE BANK AT LBJ**  
9401 LBJ FREEWAY  
DALLAS, TEXAS 75243  
**AS-BUILT PLAN**  
SUITE 104

rsf: 2,302  
scale: 3/32" = 1'-0"  
date: 10.09.06

**gco studio**  
208 north market street  
suite 420  
dallas, texas 75202  
214.420.4646