


KEY PLAN



10440 North Central Expy., Suite 500  
 Dallas, Texas 75231  
 972.437.2444

FOR LEASING INFORMATION  
 CONTACT: JAROD JAGGERS  
 JJAGGERS@PILLARCOMMERCIAL.COM

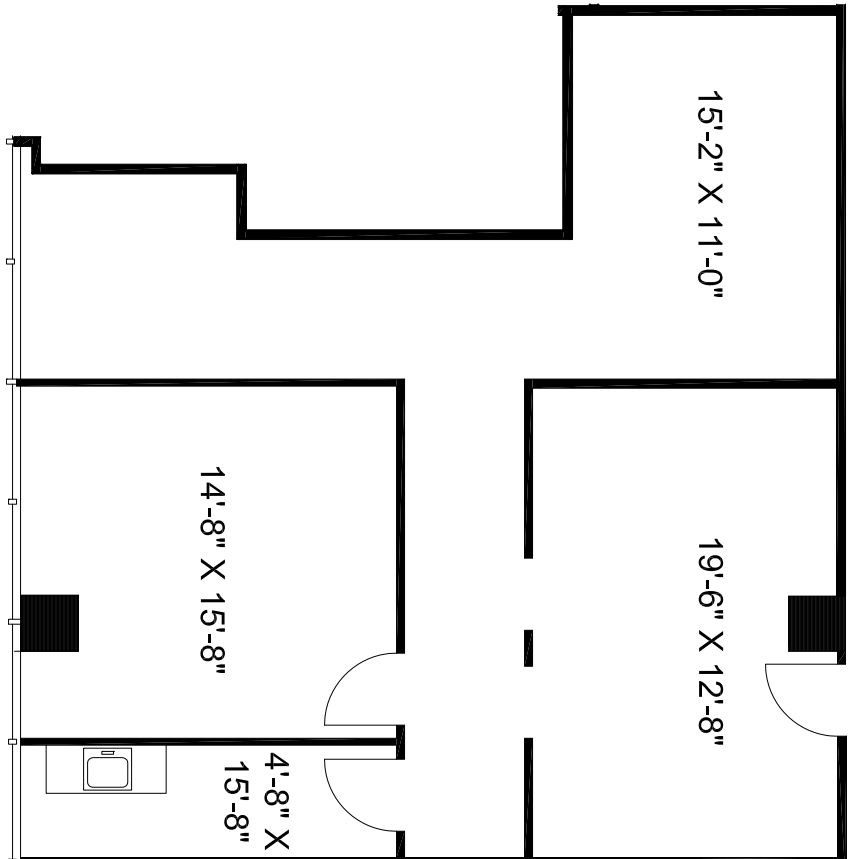

**6500 GREENVILLE**  
 DALLAS, TEXAS 75206

**AS-BUILT PLAN**  
 SUITE 201

rsf: 1,184

scale: 1/8" = 1'-0"

date: 05.28.09

**gc studio**  
 208 north market street  
 suite 420  
 dallas, texas 75202  
 214.420.4646