


KEY PLAN



10440 N. Central Expy., Suite 500
Dallas, TX 75231
972.437.2444

FOR LEASING INFORMATION
CONTACT: ALEXIS MARTINEZ
AMARTINEZ@PILLARCOMMERCIAL.COM

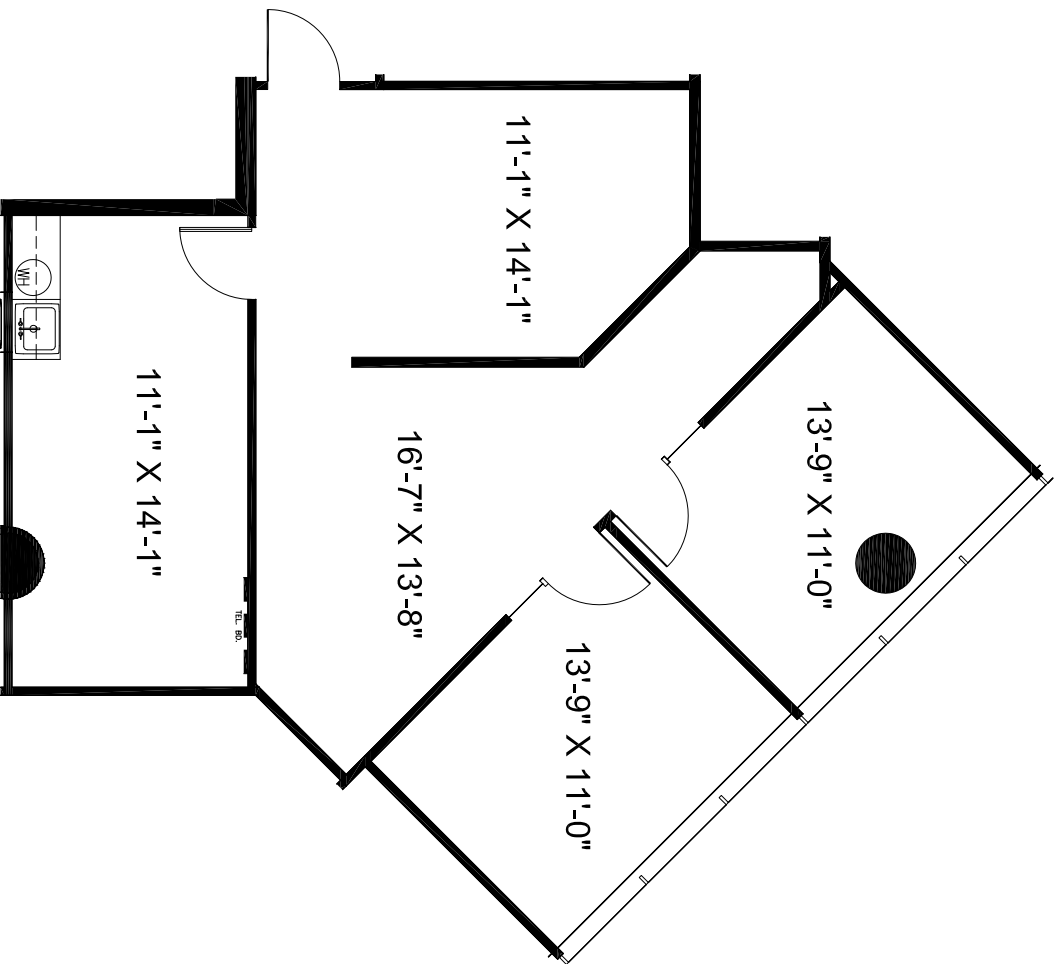

7920 BELT LINE

7920 BELT LINE ROAD
DALLAS, TEXAS 75254

AS-BUILT PLAN
SUITE 920

rsf: 1,394

scale: 1/8" = 1'-0"

date: 06.21.10



208 north market street
suite 420
dallas, texas 75202
214.420.4646