


KEY PLAN



10440 N. Central Expy., Suite 500  
 Dallas, TX 75231  
 972.437.2444

FOR LEASING INFORMATION  
 CONTACT: ALEXIS MARTINEZ  
 AMARTINEZ@PILLARCOMMERCIAL.COM

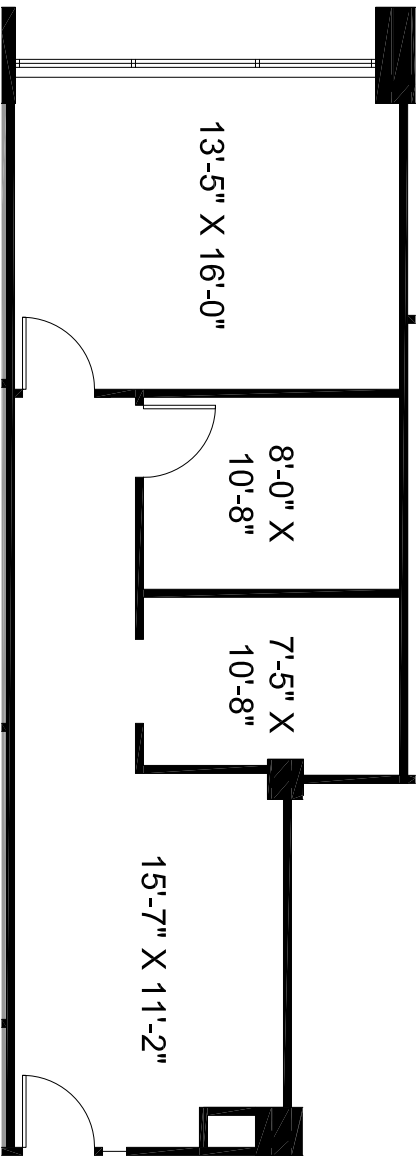

# TOLL HILL EAST

5440 HARVEST HILL  
 DALLAS, TEXAS 75230

AS-BUILT PLAN  
 SUITE 212

rsf: 771

scale: 1/8" = 1'-0"

date: 03.17.10



208 north market street  
 suite 420  
 dallas, texas 75202  
 214.420.4646