

KEY PLAN




10440 N. Central Expy., Suite 500

Dallas, TX 75231

972.437.2444

FOR LEASING INFORMATION
 CONTACT: ALEXIS MARTINEZ
 AMARTINEZ@PILLARCOMMERCIAL.COM

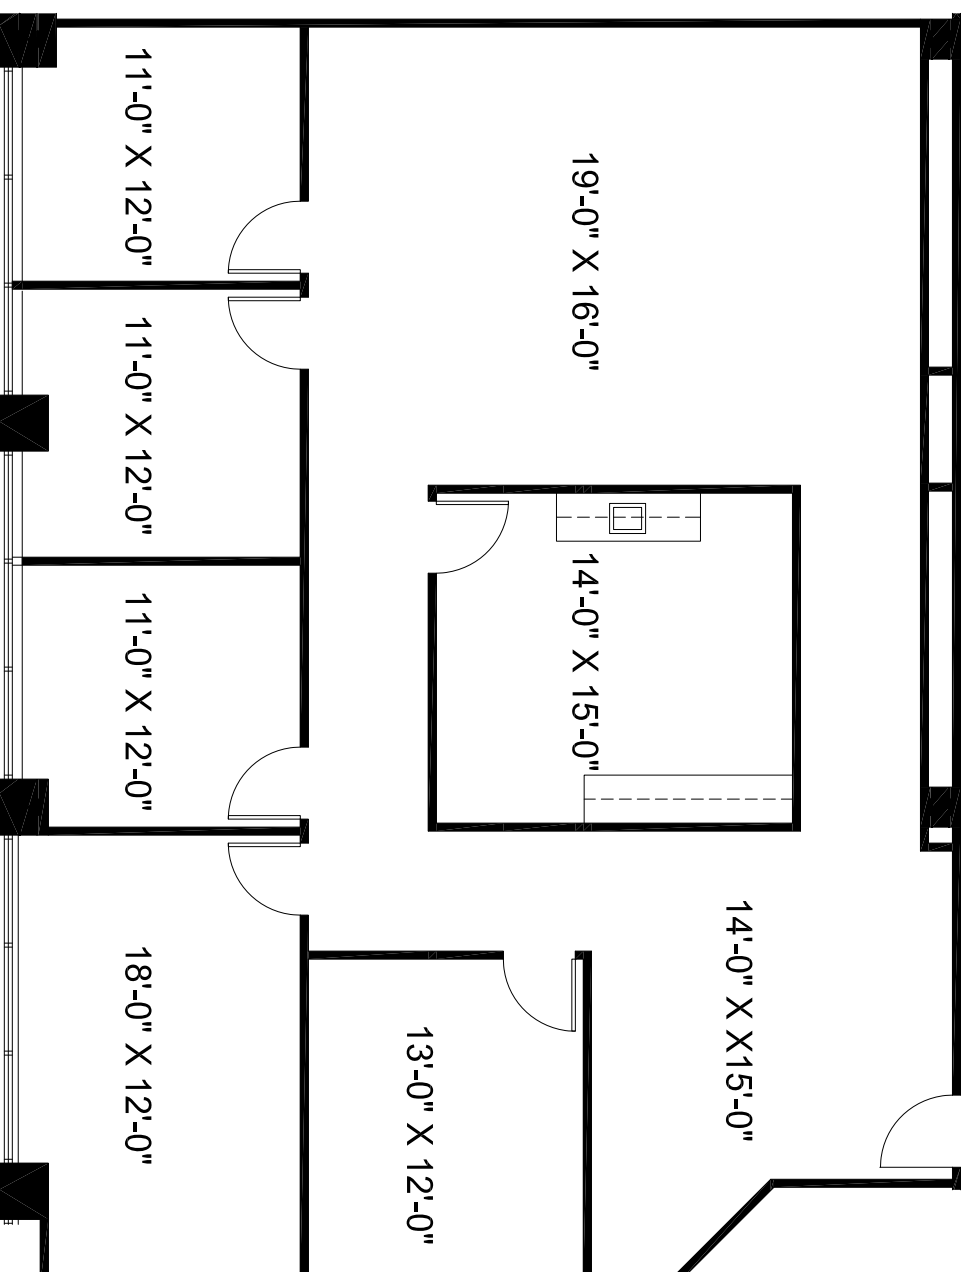

TOLL HILL WEST

5310 HARVEST HILL
 DALLAS, TEXAS 75230

AS-BUILT PLAN
 SUITE 228

rsf: 2,274

scale: n.t.s.

date: 09.29.09



208 north market street
 suite 420
 dallas, texas 75202
 214.420.4646