


KEY PLAN



10440 N. Central Expv., Suite 500
Dallas, TX 75231
972.437.2444

FOR LEASING INFORMATION
CONTACT: ALEXIS MARTINEZ
AMARTINEZ@PILLARCOMMERCIAL.COM

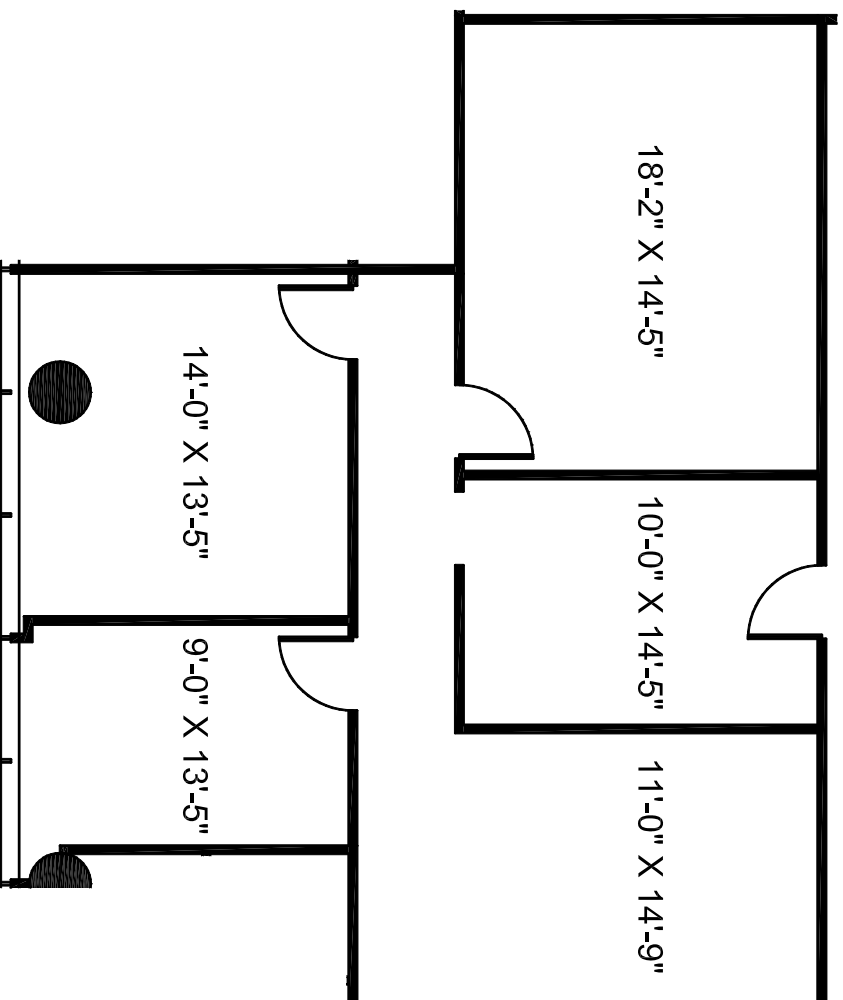

7920 BELT LINE

7920 BELT LINE ROAD
DALLAS, TEXAS 75254

AS-BUILT PLAN
SUITE 620

rsf: 1,224

scale: 1/8" = 1'-0"

date: 10.07.08



208 north market street
suite 420
dallas, texas 75202
214.420.4646