


KEY PLAN

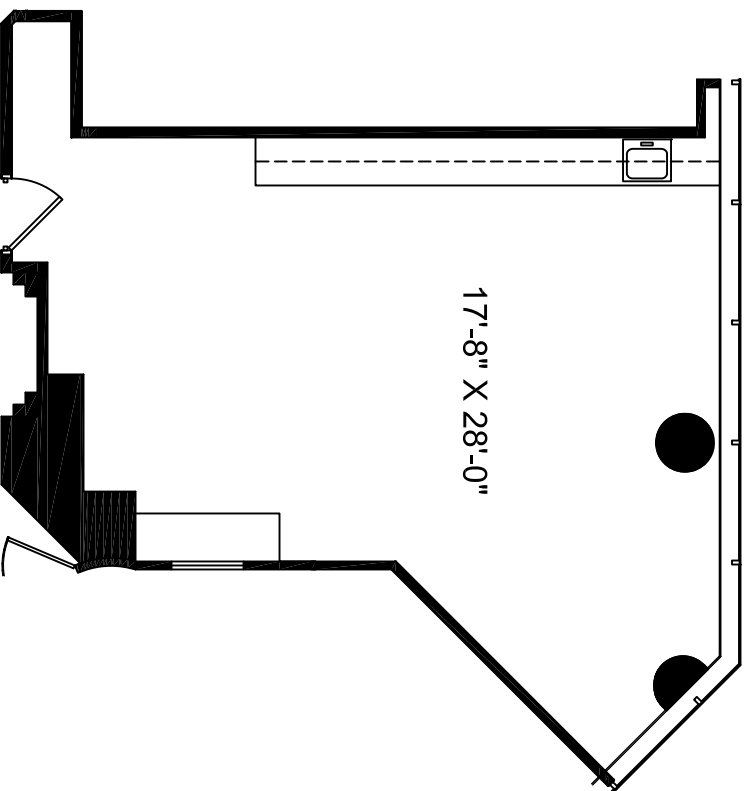

10440 North Central Expy., Suite 500
 Dallas, Texas 75231
 972.437.2444

FOR LEASING INFORMATION
 CONTACT: JAROD JAGGERS
 JJAGGERS@PILLARCOMMERCIAL.COM
 972.437.2444

CHASE BANK AT LBJ
 9401 LBJ FREEWAY
 DALLAS, TEXAS 75243

AS-BUILT PLAN
 SUITE 202

rsf: 746

scale: 1/8" = 1'-0"

date: 05.18.09



208 north market street
 suite 420
 dallas, texas 75202
 214.420.4646