


KEY PLAN

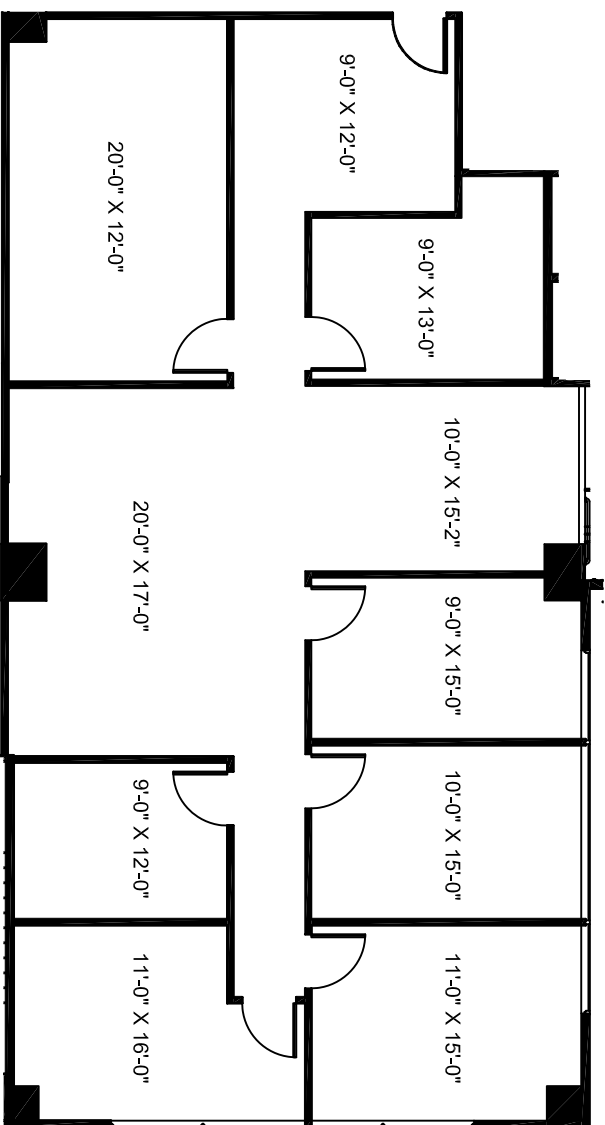

10440 N. Central Expy., Suite 500
Dallas, TX 75231
972.437.2444

FOR LEASING INFORMATION
CONTACT: ALEXIS MARTINEZ
AMARTINEZ@PILLARCOMMERCIAL.COM

WELLS FARGO TOWER

3939 BELT LINE ROAD
ADDISON, TEXAS 75001

AS-BUILT PLAN
SUITE 600

rsf: 2,218

scale: NTS

date: 02.25.10



208 north market street
suite 420
dallas, texas 75202
214.420.4646