


KEY PLAN



10440 N. Central Expv., Suite 500
Dallas, TX 75231
972.437.2444

FOR LEASING INFORMATION
CONTACT: NICK CLARK
NCLARK@PILLARCOMMERCIAL.COM

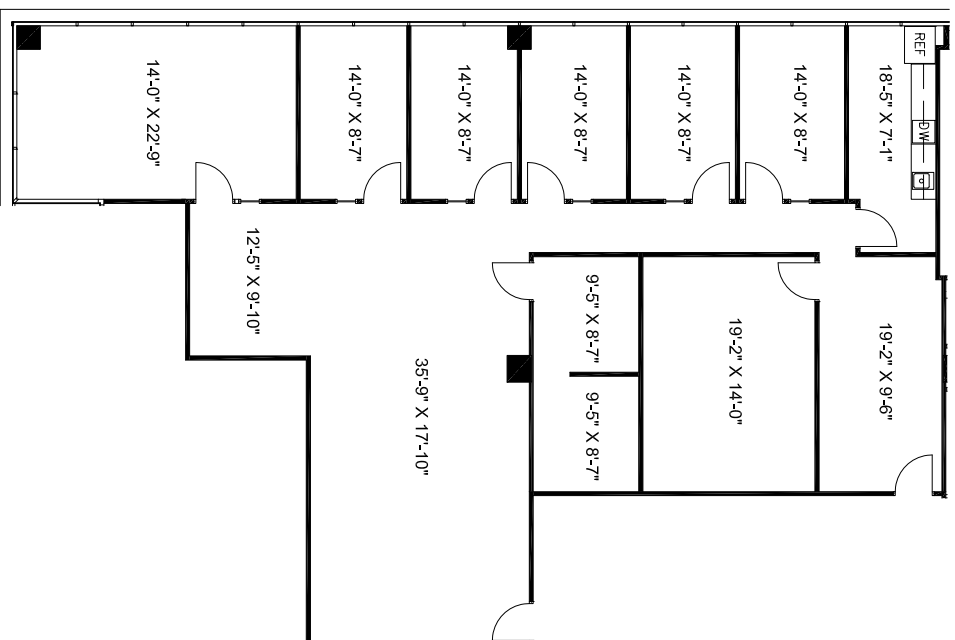

1909 WOODALL RODGERS

DALLAS, TEXAS 75201

AS-BUILT PLAN
SUITE 575

rsf: 3,145

scale: 1/16" = 1'-0"

date: 05.14.10



208 north market street
suite 420
dallas, texas 75202
214.420.4646