


KEY PLAN



10440 N. Central Expy., Suite 500  
Dallas, TX 75231  
972.437.2444

FOR LEASING INFORMATION  
CONTACT: ALEXIS MARTINEZ  
AMARTINEZ@PILLARCOMMERCIAL.COM

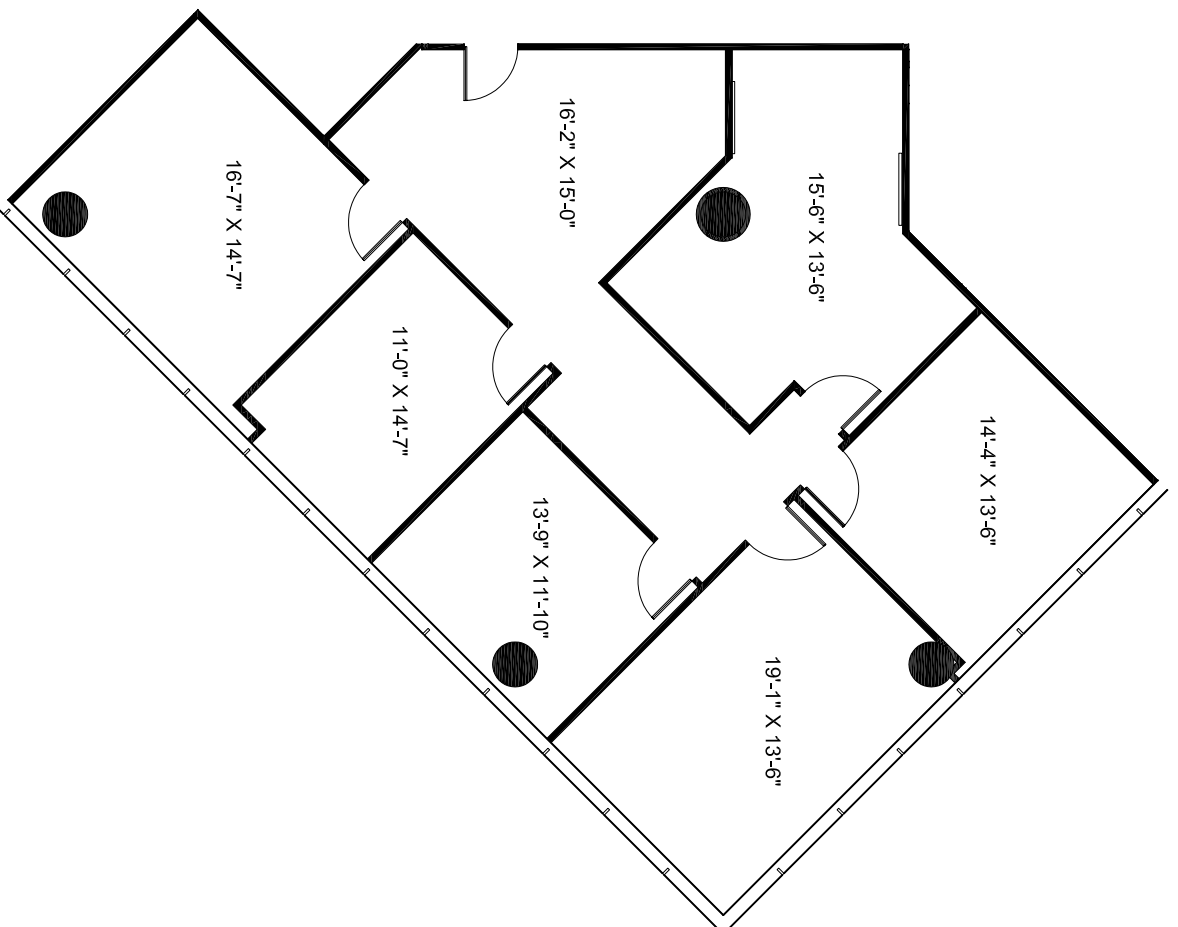

## 7920 BELT LINE

7920 BELT LINE ROAD  
DALLAS, TEXAS 75254

AS-BUILT PLAN  
SUITE 300

rsf: 2,101

scale: 3/32" = 1'-0"

date: 06.02.08



208 north market street  
suite 420  
dallas, texas 75202  
214.420.4646