


KEY PLAN



10440 N. Central Expy., Suite 500
 Dallas, TX 75231
 972.437.2444

FOR LEASING INFORMATION
 CONTACT: ALEXIS MARTINEZ
 AMARTINEZ@PILLARCOMMERCIAL.COM

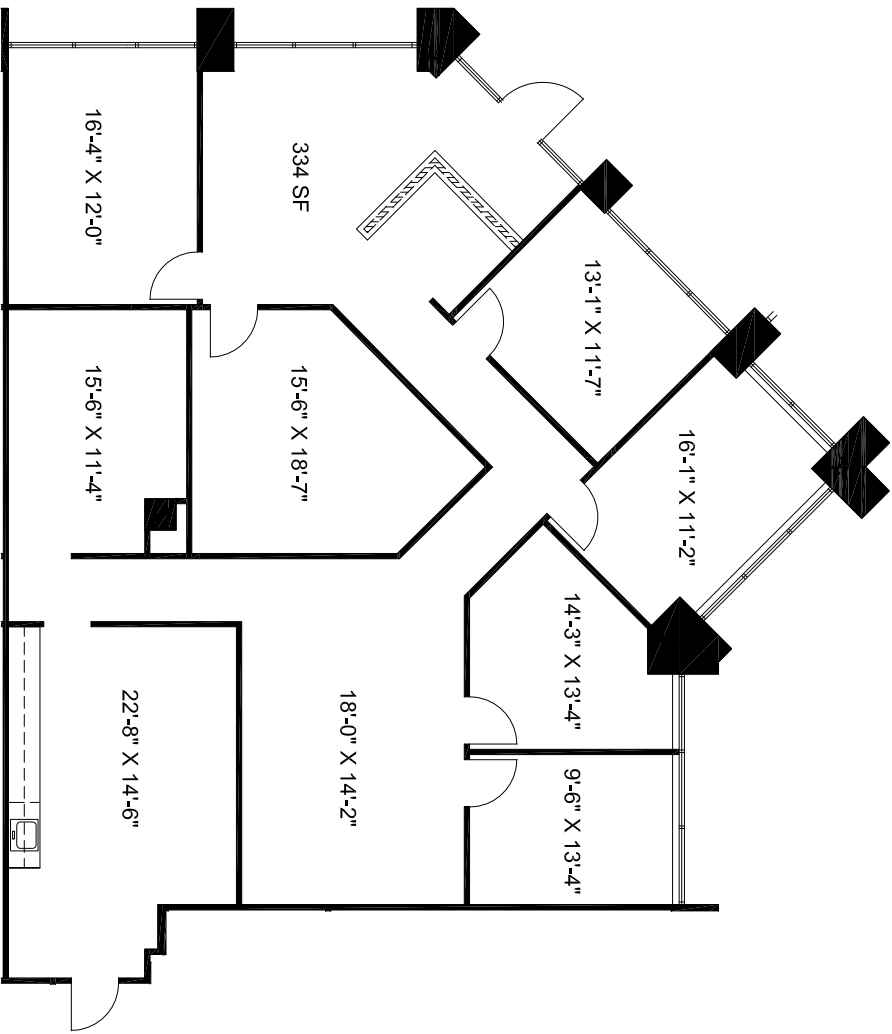

TOLL HILL EAST

5440 HARVEST HILL
 DALLAS, TEXAS 75230

AS-BUILT PLAN
 SUITE 185

rsf: 2,789

scale: NTS

date: 05.10.10



208 north market street
 suite 420
 dallas, texas 75202
 214.420.4646