


KEY PLAN

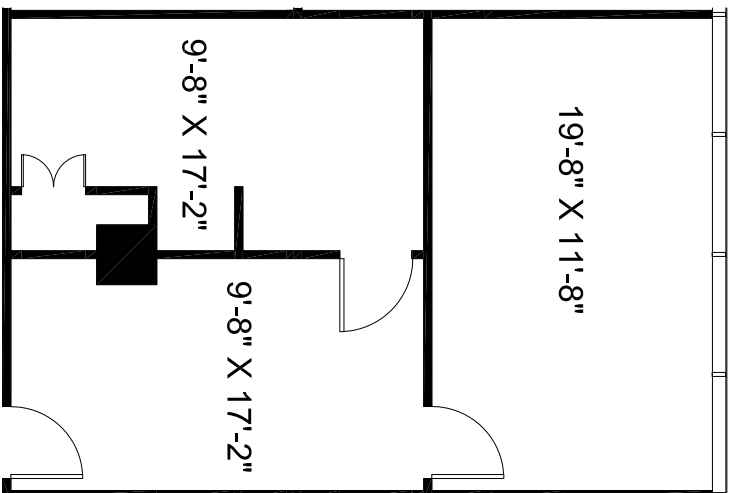

10440 N. Central Expy., Suite 500
 Dallas, TX 75231
 972.437.2444

FOR LEASING INFORMATION
 CONTACT: JAROD JAGGERS
 JJAGGERS@PILLARCOMMERCIAL.COM

7515
 7515 GREENVILLE AVENUE
 DALLAS, TEXAS 75206

AS-BUILT PLAN
 SUITE 713

rsf: 678

scale: 1/8" = 1'-0"

date: 01.07.10

gc studio
 208 north market street
 suite 420
 dallas, texas 75202
 214.420.4646