


KEY PLAN

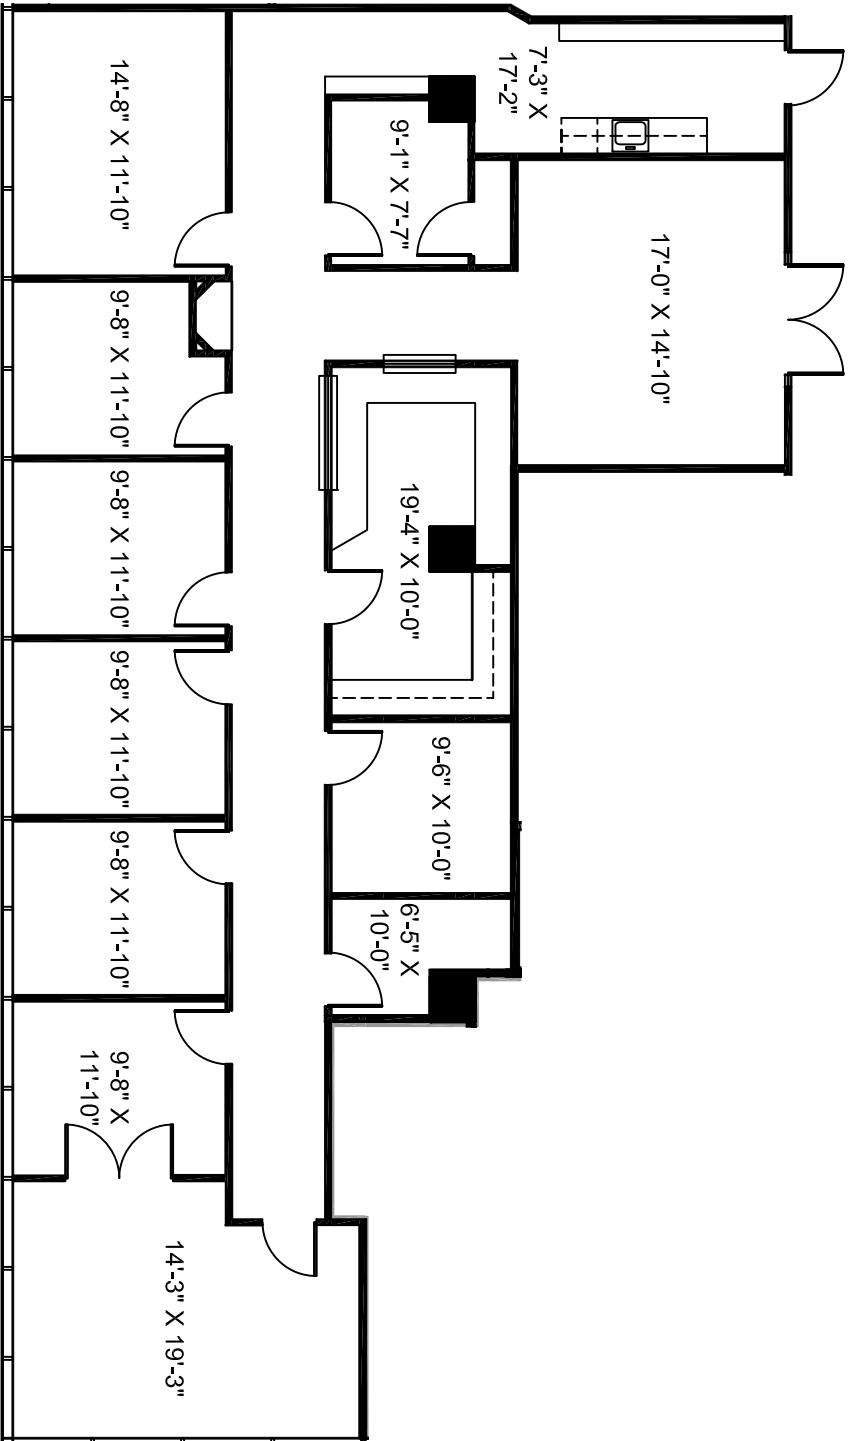

10440 N. Central Expy., Suite 500
 Dallas, TX 75231
 972.437.2444

FOR LEASING INFORMATION
 CONTACT: JAROD JAGGERS
 JJAGGERS@PILLARCOMMERCIAL.COM

7515
 7515 GREENVILLE AVENUE
 DALLAS, TEXAS 75206
AS-BUILT PLAN
 SUITE 1000

rsf: 2,733

scale: NTS

date: 09.16.09

gcstudio
 208 north market street
 suite 420
 dallas, texas 75202
 214.420.4646