


KEY PLAN

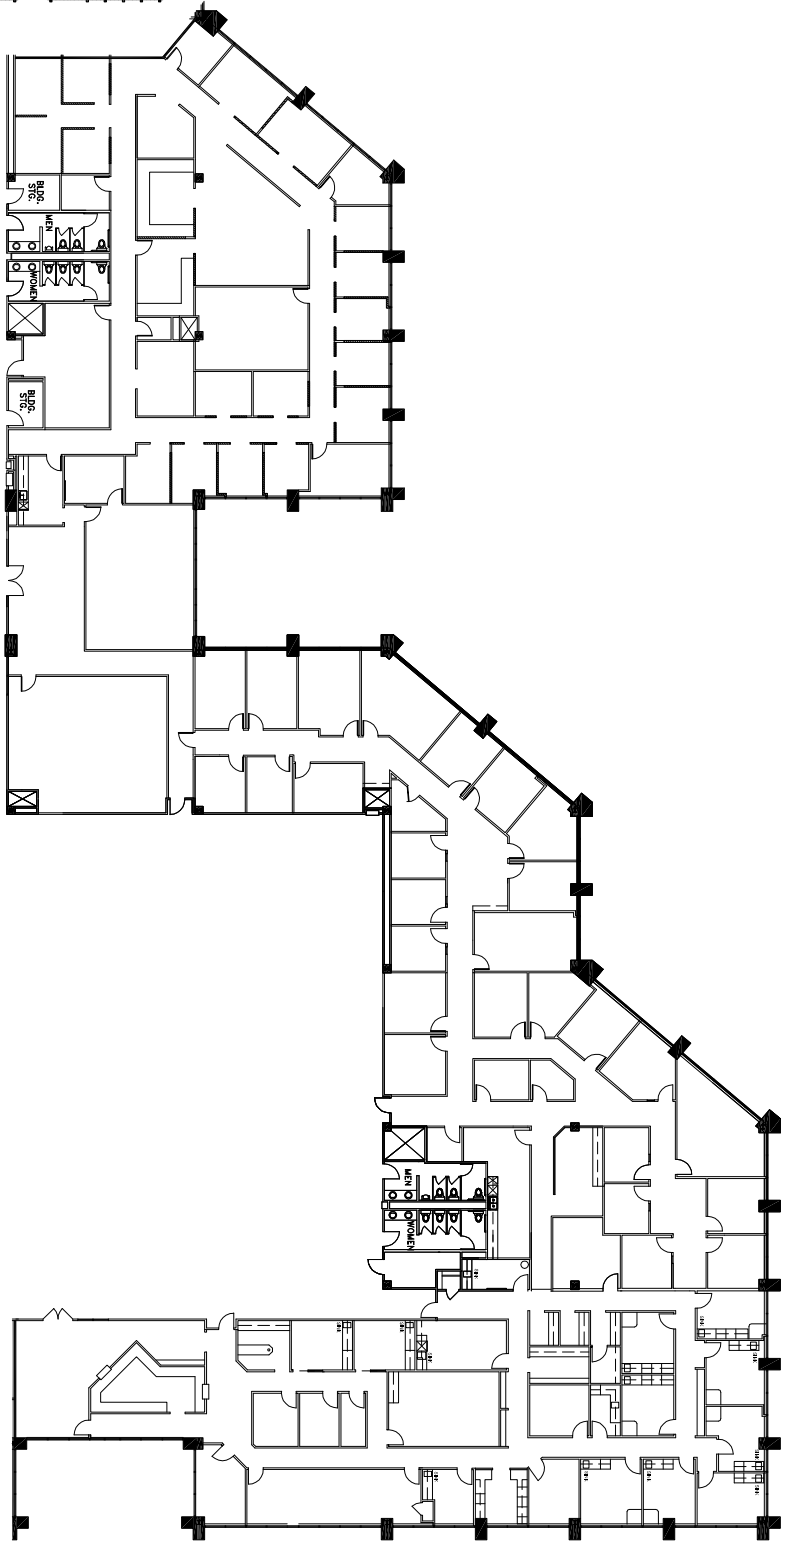

10440 N. Central Expy., Suite 500
 Dallas, TX 75231
 972.437.2444

FOR LEASING INFORMATION
 CONTACT: ALEXIS MARTINEZ
 AMARTINEZ@PILLARCOMMERCIAL.COM

TOLL HILL WEST

5310 HARVEST HILL
 DALLAS, TEXAS 75230

AS-BUILT PLAN
 SUITE 298 & 299

rsf: 25,148

scale: n.t.s.

date: 03.05.10



208 north market street
 suite 420
 dallas, texas 75202
 214.420.4646