

KEY PLAN



10440 N. Central Expy., Suite 500


Dallas, TX 75231

972.437.2444

FOR LEASING INFORMATION

CONTACT: ALEXIS MARTINEZ

AMARTINEZ@PILLARCOMMERCIAL.COM

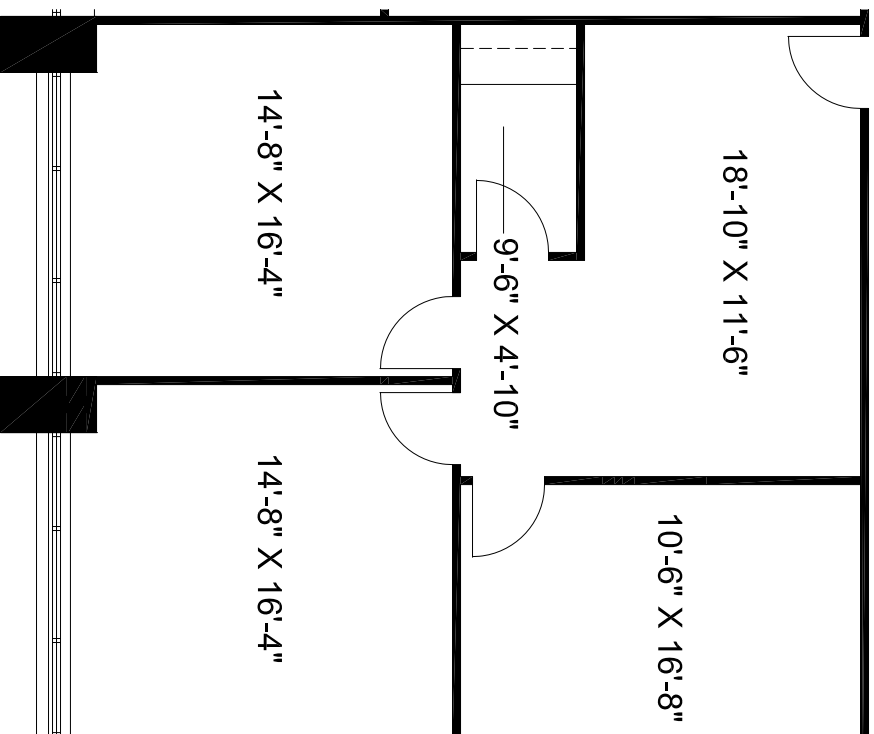

TOLL HILL EAST

5440 HARVEST HILL
DALLAS, TEXAS 75230

AS-BUILT PLAN
SUITE 154

rsf: 1,126

scale: 1/8" = 1'-0"

date: 09.29.09



208 north market street
suite 420
dallas, texas 75202
214.420.4646