


KEY PLAN

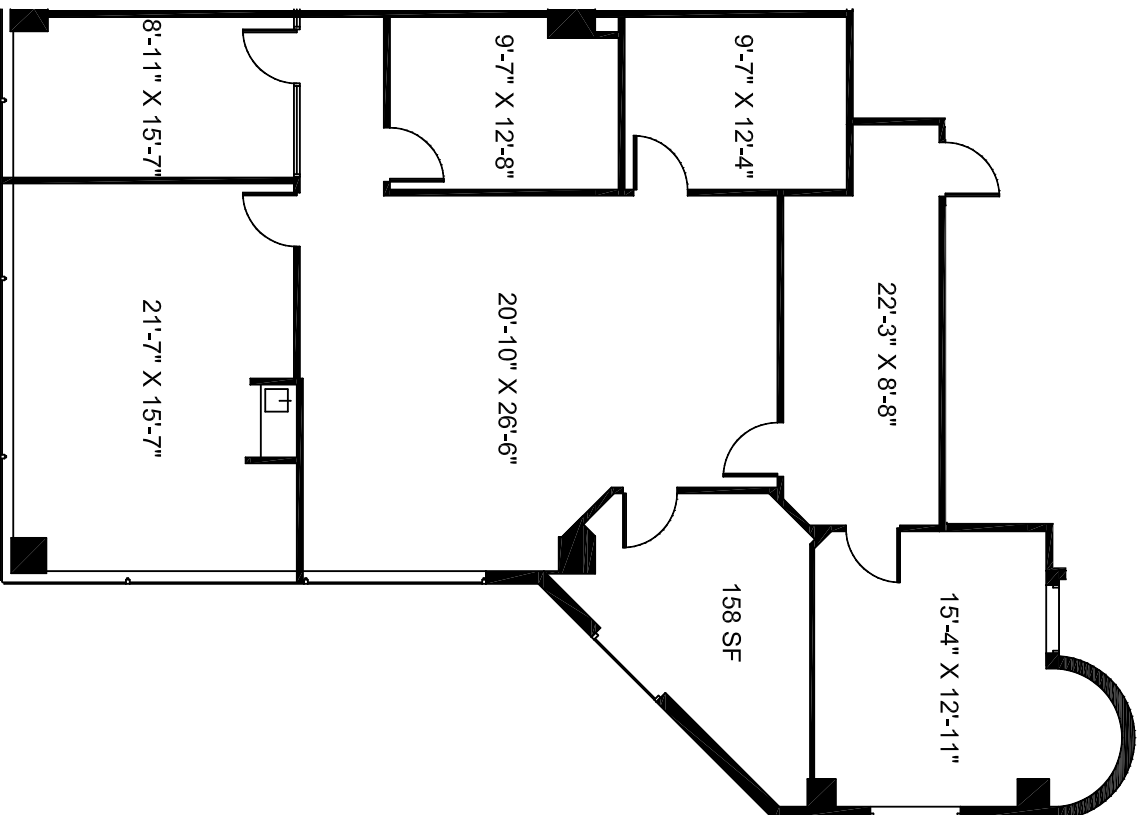

10440 N. Central Expy., Suite 500  
 Dallas, TX 75231  
 972.437.2444

FOR LEASING INFORMATION  
 CONTACT: ALEXIS MARTINEZ  
 AMARTINEZ@PILLARCOMMERCIAL.COM

# WELLS FARGO TOWER

3939 BELT LINE ROAD  
 ADDISON, TEXAS 75001

AS-BUILT PLAN  
 SUITE 450

rsf: 2,273

scale: 3/32" = 1'-0"

date: 02.26.09



208 north market street  
 suite 420  
 dallas, texas 75202  
 214.420.4646