


KEY PLAN

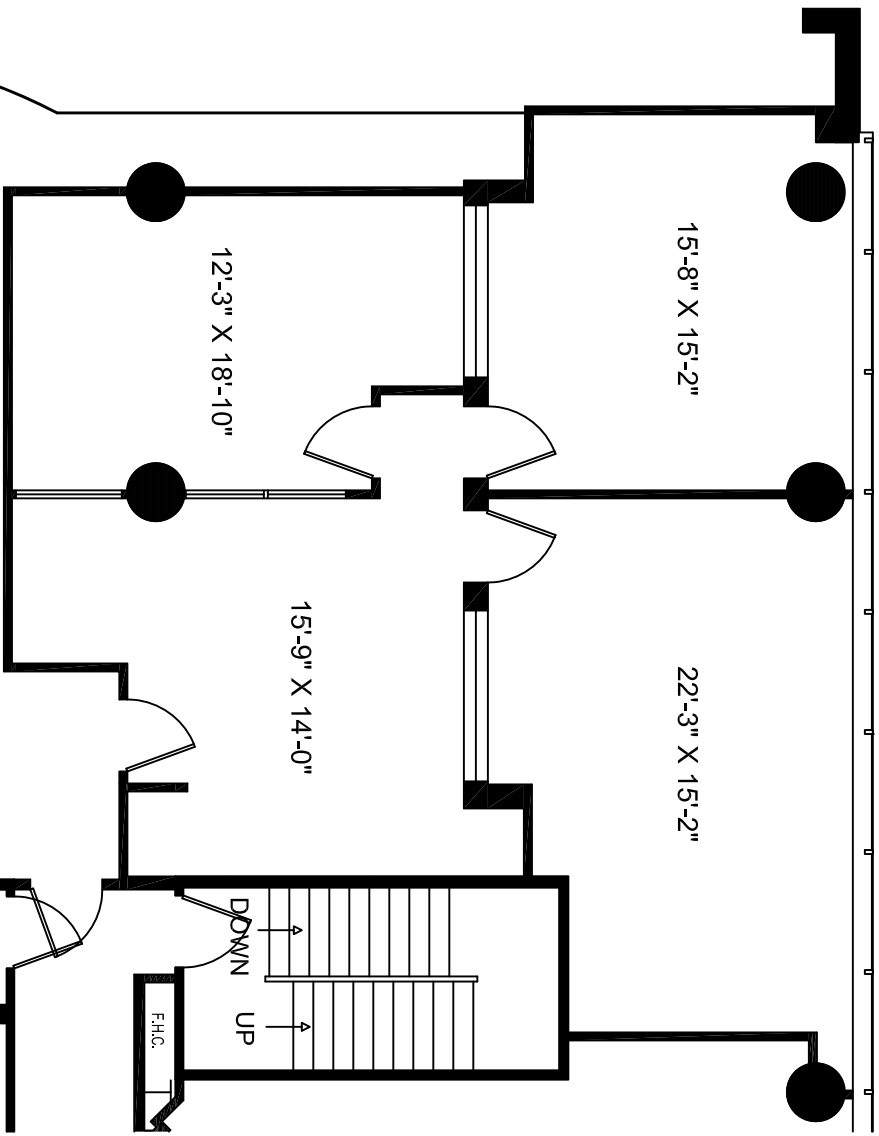

PILLAR
COMMERCIAL
10440 North Central Expy., Suite 500
Dallas, Texas 75231
972.437.2444

CHASE BANK AT LBJ
9401 LBJ FREEWAY
DALLAS, TEXAS 75243
AS-BUILT PLAN
SUITE 200

rsf: 1,299
scale: 1/8" = 1'-0"
date: 01.20.09

gcstudio
208 north market street
dallas, texas 75202
214.420.4646