


KEY PLAN

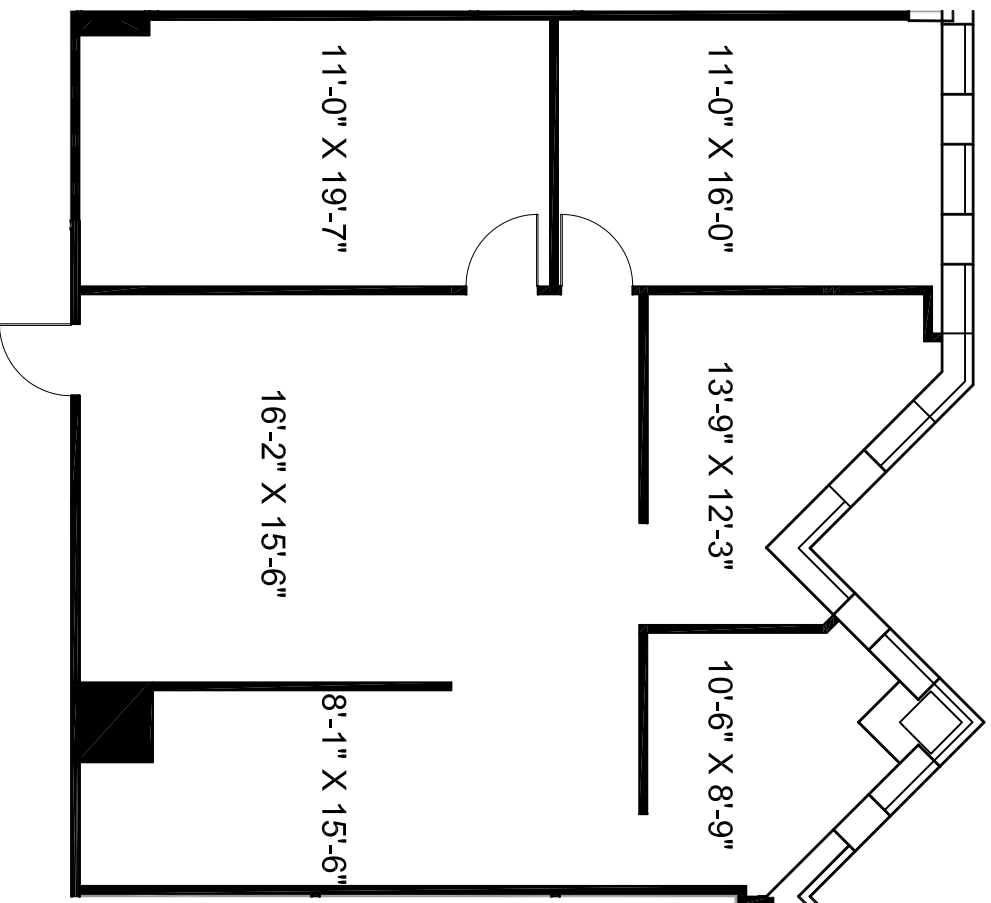

10440 N. Central Expy., Suite 500  
 Dallas, TX 75231  
 972.437.2444

FOR LEASING INFORMATION  
 CONTACT: NICK CLARK  
 NCLARK@PILLARCOMMERCIAL.COM

**SEARCH PLAZA**  
 10670 N. CENTRAL EXPRESSWAY  
 DALLAS, TEXAS 75231

**AS-BUILT PLAN**  
 SUITE 400

rsf: 1,455

scale: n.t.s.

date: 06.10.09

208 north market street  
 suite 420  
 dallas, texas 75202  
 214.420.4646

