


KEY PLAN

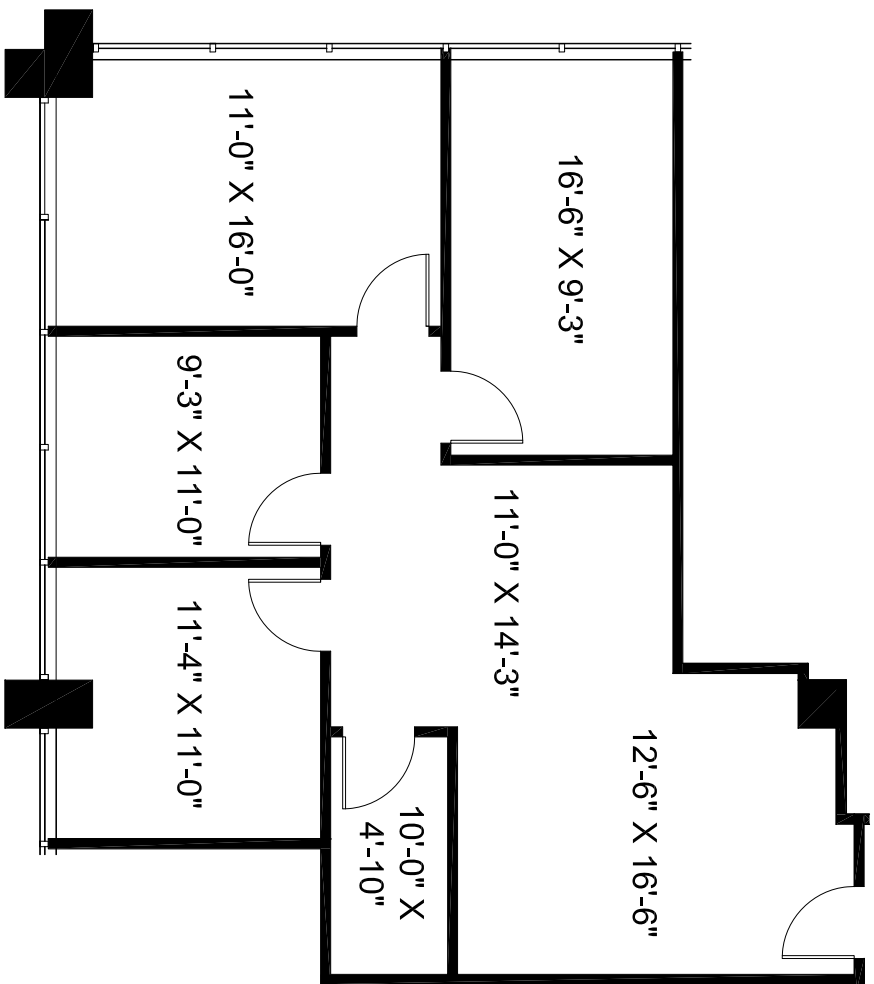

10440 N. Central Expy., Suite 500  
 Dallas, TX 75231  
 972.437.2444

FOR LEASING INFORMATION  
 CONTACT: NICK CLARK  
 NCLARK@PILLARCOMMERCIAL.COM

# WELLS FARGO TOWER

800 W. AIRPORT FREEWAY  
 IRVING, TEXAS 75062  
**AS-BUILT PLAN**  
 SUITE 1033

rsf: 1,213

scale: 1/8" = 1'-0"

date: 05.04.10



208 north market street  
 suite 420  
 dallas, texas 75202  
 214.420.4646