

KEY PLAN




10440 North Central Expy., Suite 500

Dallas, Texas 75231

972.437.2444

FOR LEASING INFORMATION
CONTACT: JAROD JAGGERS
JJAGGERS@PILLARCOMMERCIAL.COM

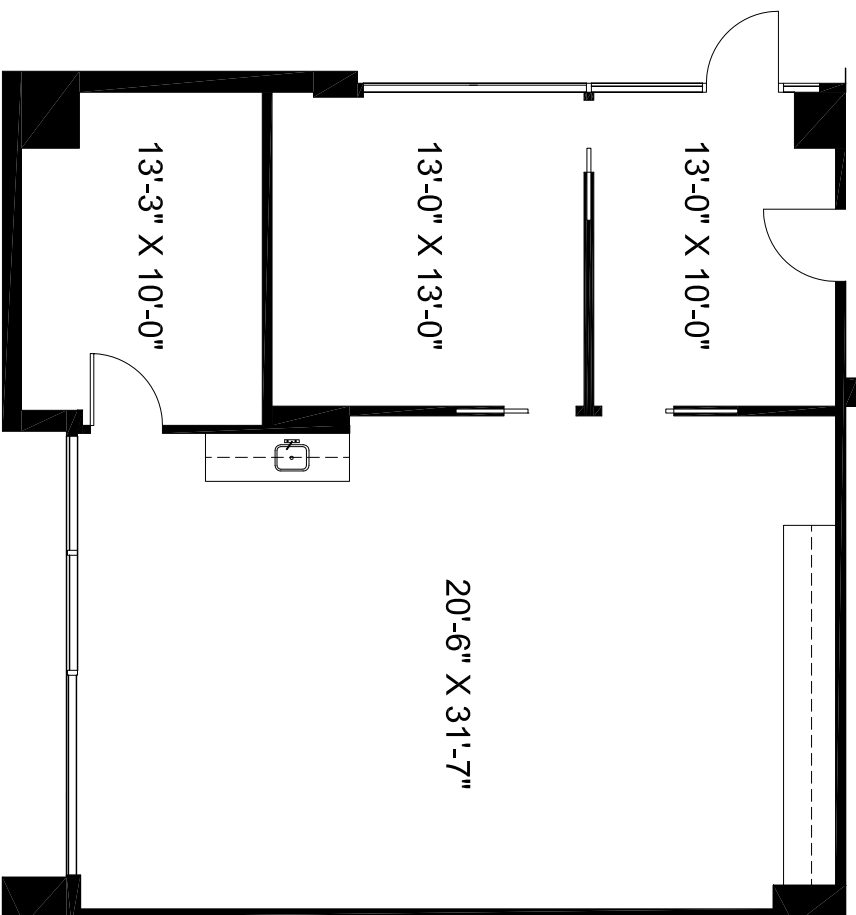

6500 GREENVILLE

DALLAS, TEXAS 75206

AS-BUILT PLAN

SUITE 120

rsf: 1,291

scale: 1/8" = 1'-0"

date: 05.10.10



208 north market street
suite 420
dallas, texas 75202
214.420.4646