


KEY PLAN

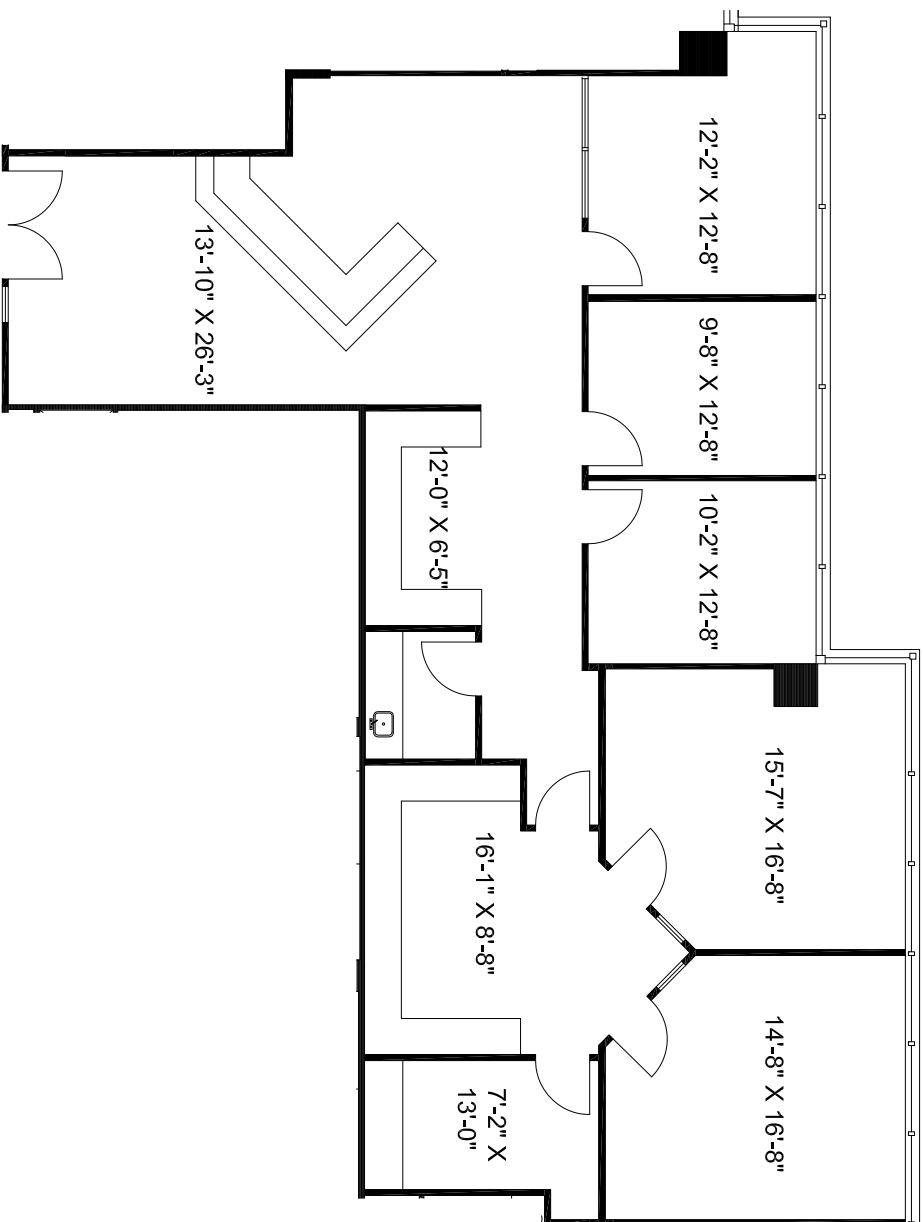

10440 North Central Expy., Suite 500  
 Dallas, Texas 75231  
 972.437.2444

FOR LEASING INFORMATION  
 CONTACT: JAROD JAGGERS  
 JJAGGERS@PILLARCOMMERCIAL.COM

6500 GREENVILLE  
 DALLAS, TEXAS 75206

AS-BUILT PLAN  
 SUITE 515

rsf: 2,358

scale: NTS

date: 05.19.09



208 north market street  
 suite 420  
 dallas, texas 75202  
 214.420.4646